

**NOTE:** This project to be constructed in accordance with the current Specifications of The Franklin County Sanitary Engineering Dept. together with General Provisions of The Village of Gahanna, Ohio. All trenches in or crossing paved, or future paved areas shall be backfilled with approved granular material, no less than (3) feet behind the curb or edge of pavement.

The Contractor shall be held responsible for damage to existing sewers, water and gas lines. The exact location of Y's shall be determined by the Engineer at the time of construction.

Where two house services cross in a single excavation they shall be placed at least 18" apart and shall have a fall of not less than 1/8" per foot.


The Contractor's specific attention is directed to the requirements of either the infiltration or exfiltration tests as specified by the Franklin County Sanitary Engineering Department.

Whenever the invert of the proposed sewer is at or above original ground, the trench shall be excavated to 6 inches below original ground and backfilled to 6" below the invert elevation with tamped bank run gravel.


B.M. - Spike in East Side of Pole #28-B-3 West Side State Route 62 120± North of E Heil Drive - Elev. 804.05

HEIL SUBDIVISION NO. 2

**LEGEND**

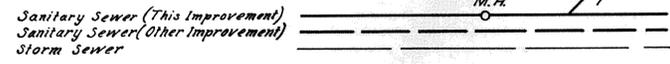

**STREET**

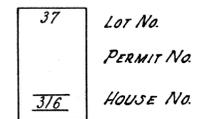


**ESTIMATE OF QUANTITIES**

ITEM	DESCRIPTION	QUANTITY	UNIT
1	8" DIA. STANDARD STRENGTH PIPE SEWER	608	Lin.Ft.
2	6" DIA. STANDARD STRENGTH PIPE SEWER	160	Lin.Ft.
3	6" DIA. "Y" BRANCH STOPPER, "Y" POLE	11	Each
4	STANDARD MANHOLE UNDER 12" DEEP	3	Each
5	CLASS "C" CONCRETE	27	Cu.Yd.

**REFERENCE STANDARD DRAWINGS**

Type "A" Manhole, City of Columbus AA S-5  
 Typical Riser & Cleanout, Franklin County Sanitary Engineering Dept. S-4

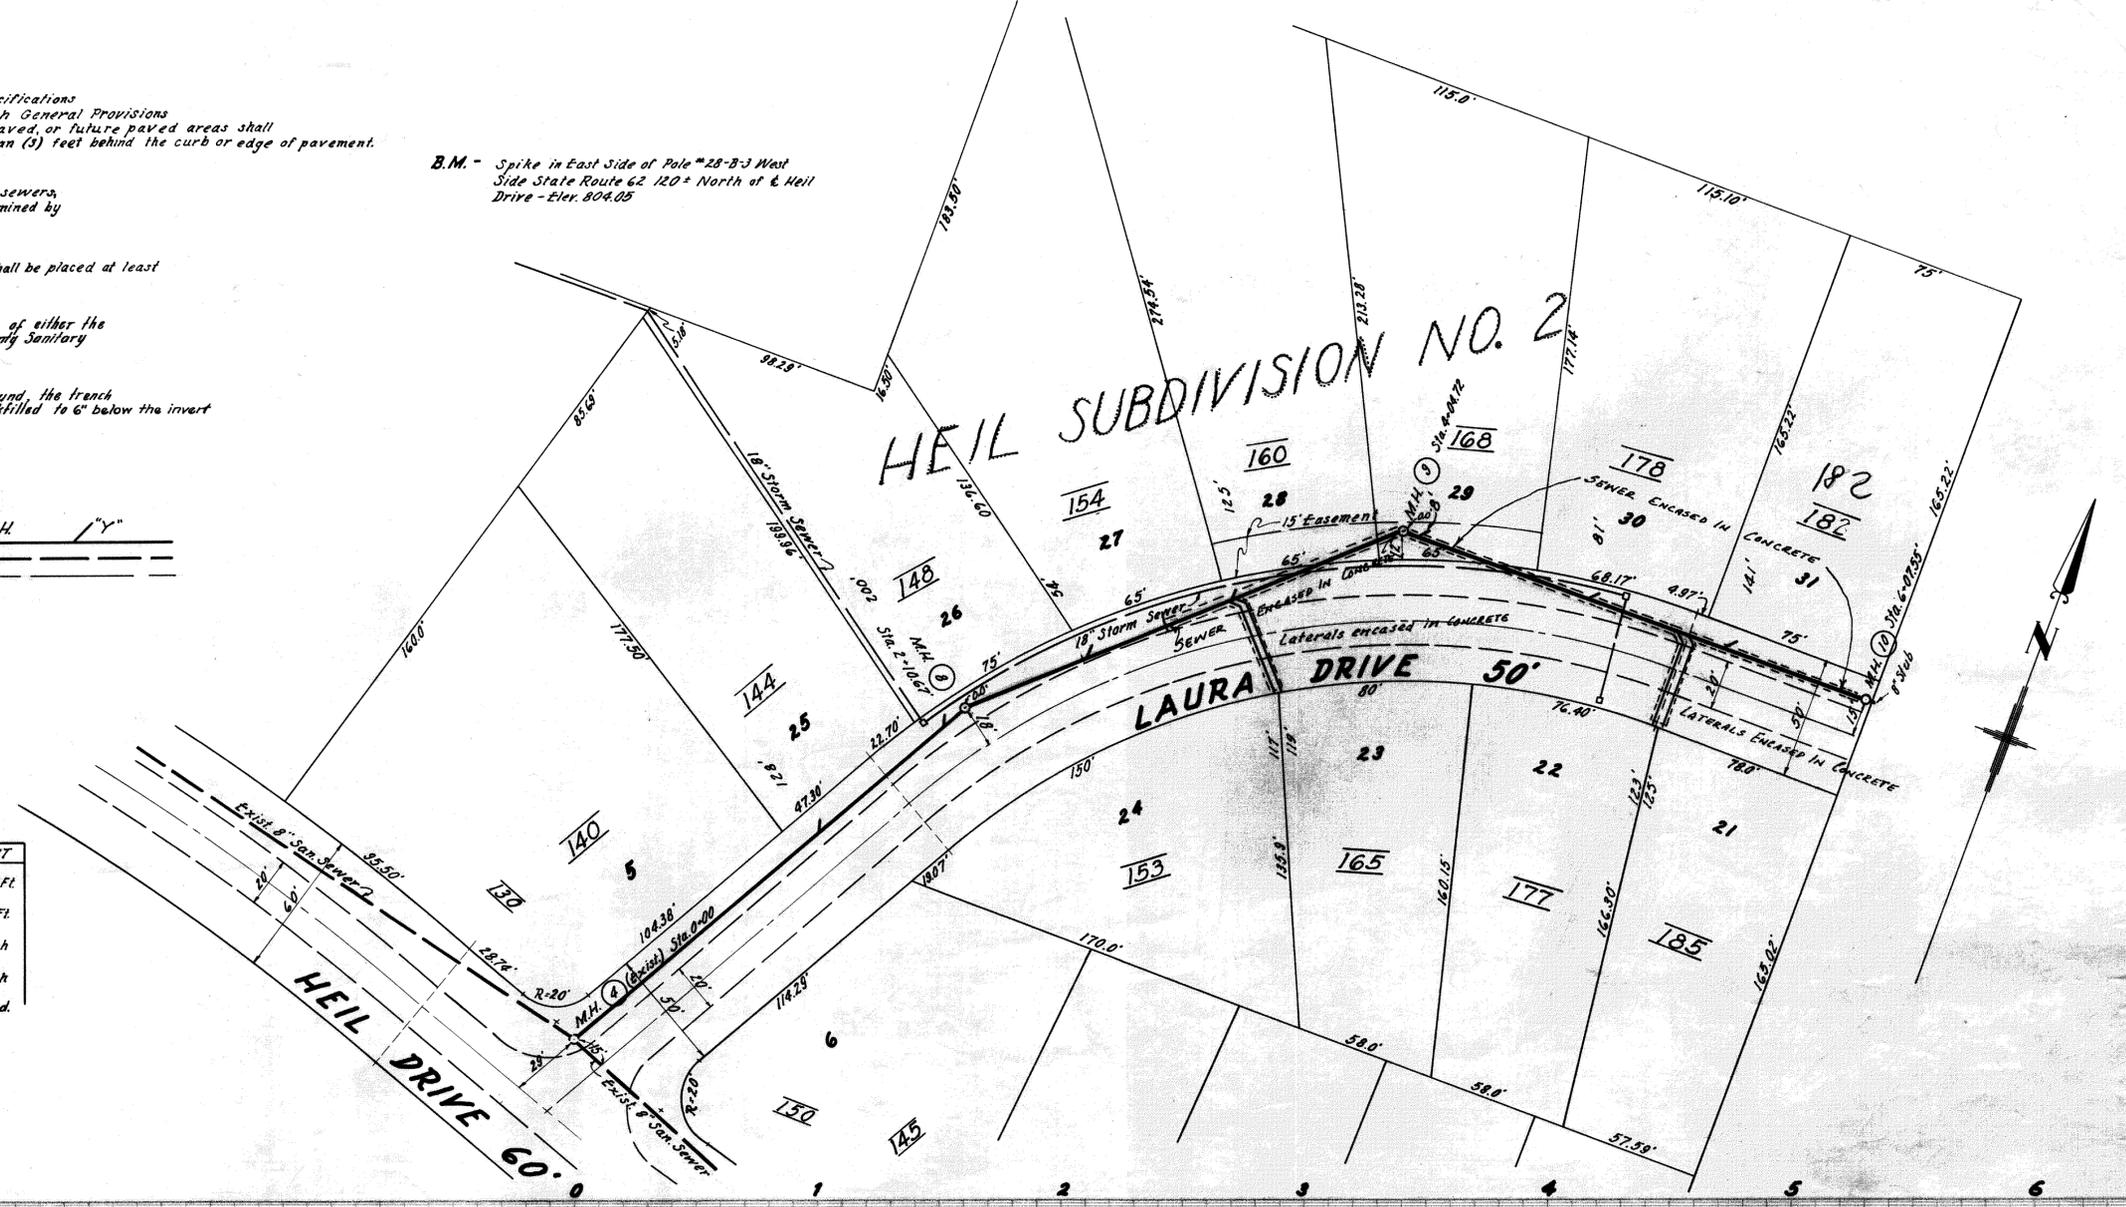

Approved this 16 day of July 1957

John S. Alton  
 Village Engineer

Approved this 16 day of July 1957



Phily S. Weserall  
 Mayor

Approved this 16 day of July 1957

Norman D. Hester  
 Board of Trustees of Public Affairs

The Jennings Lawrence Co.  
 Civil & Municipal Engineers  
 Columbus, Ohio

Roland H. Edwards  
 Registered Engineer

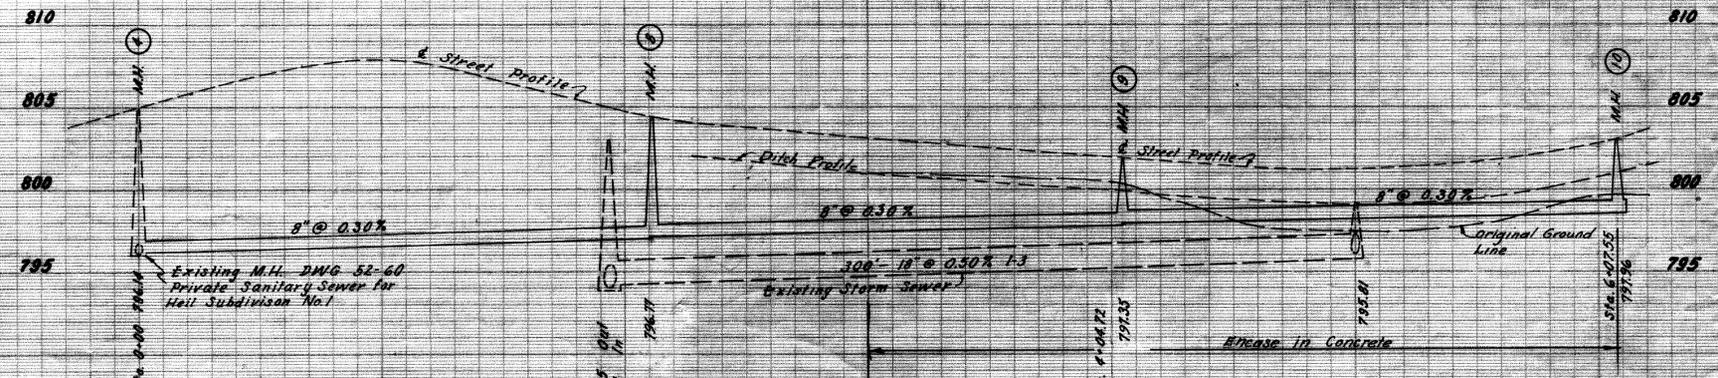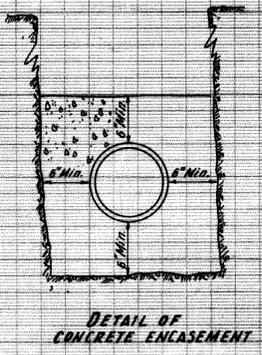

**GAHANNA, OHIO**  
**PRIVATE SANITARY SEWER**  
**IN LAURA DRIVE**  
 for  
**HEIL SUBDIVISION NO. 2**  
 Horiz. 1"=40'  
 SCALE VERT. 1"=6' JUNE 1957

THE JENNINGS - LAWRENCE CO.  
 CIVIL & MUNICIPAL ENGINEERS  
 COLUMBUS, OHIO

DWG. No. 52-61  
 3a-54

Revised as constructed 4-6-57